
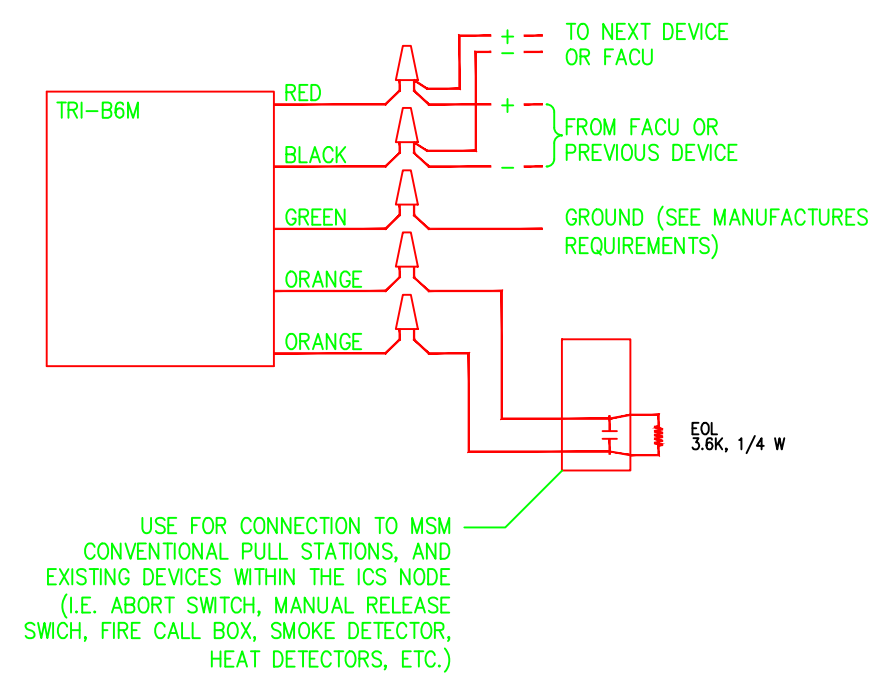
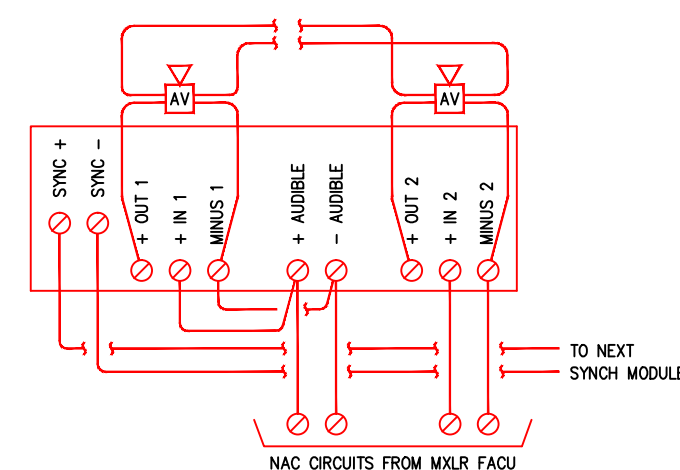
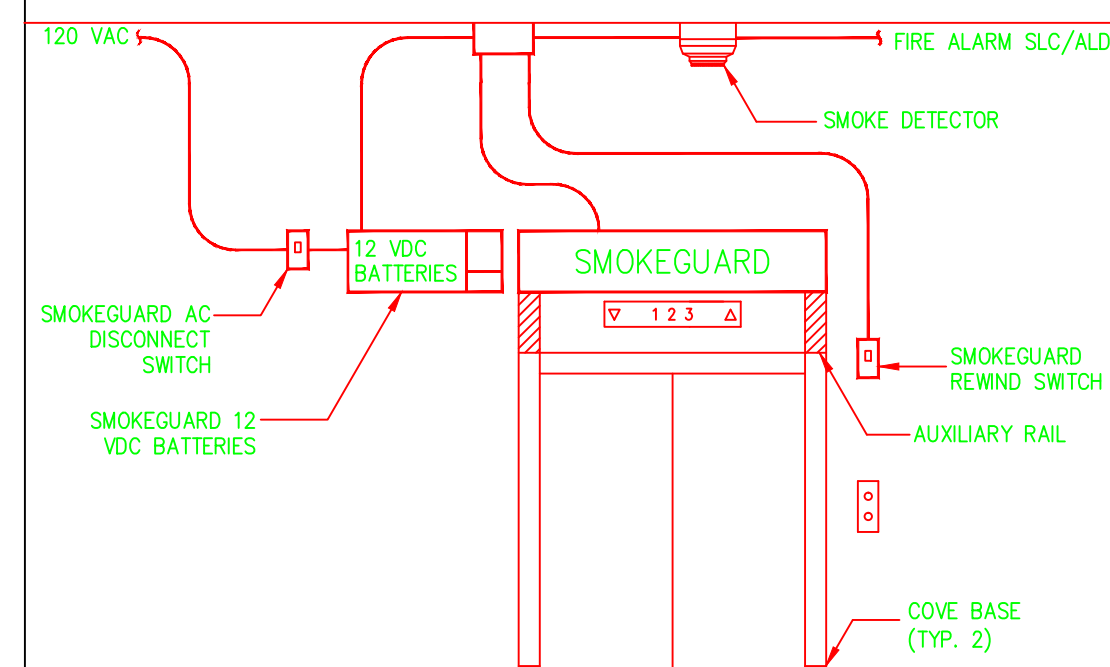
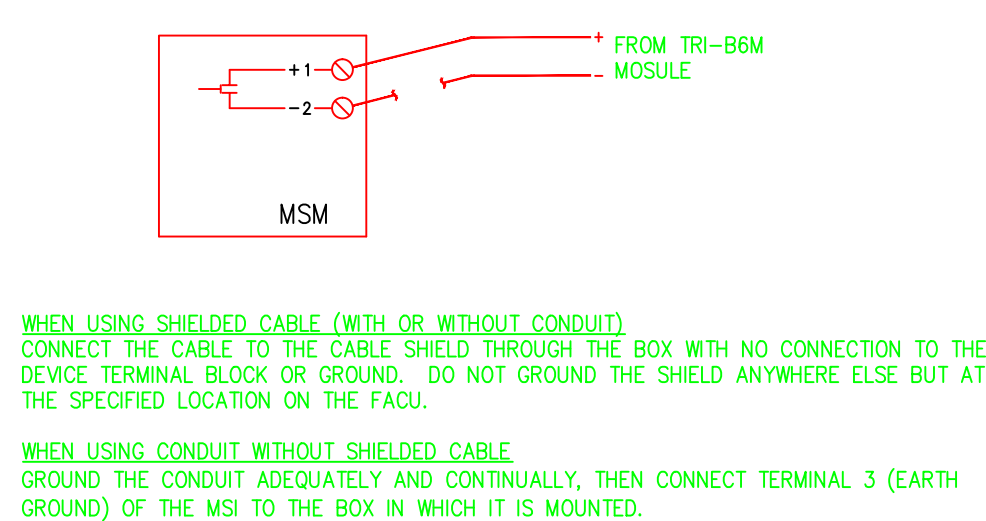
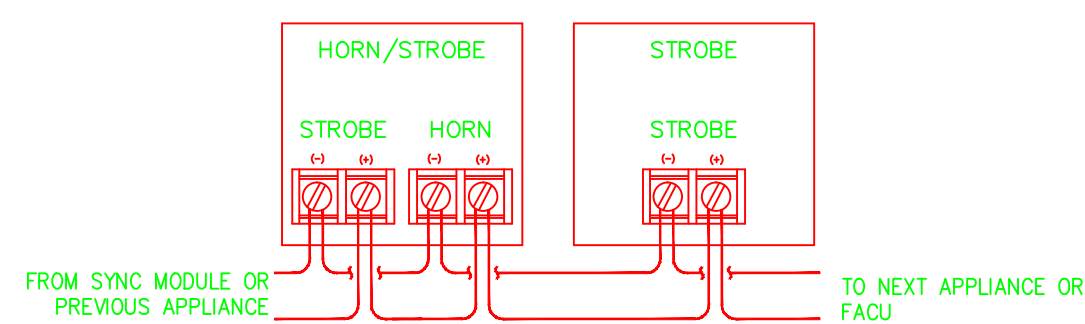
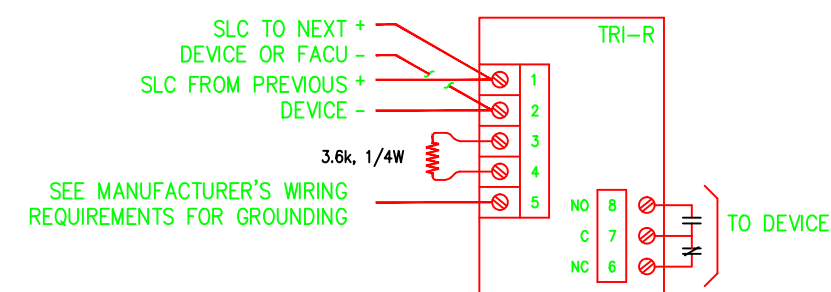
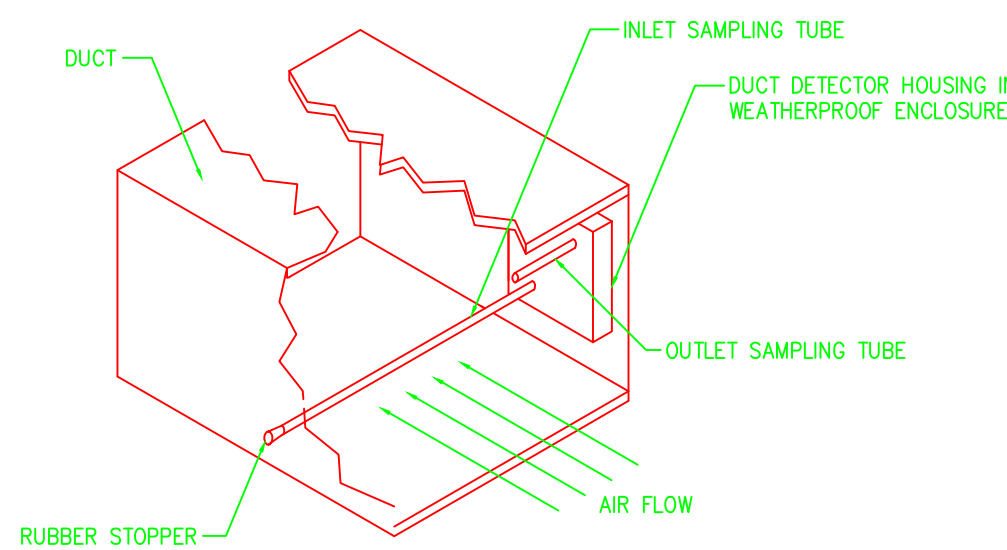


- LEGEND

- | | | |
|-------|-------|--|
| L1-01 | ① | SMOKE DETECTOR, ADDRESS AS NOTED |
| L1-02 | ②S | DUCT SMOKE DETECTOR, ADDRESS AS NOTED |
| L1-03 | ③ | FIRE CALL BOX, ADDRESS AS NOTED |
| FA-01 | FA-01 | FIRE ALARM SYSTEM CONTROL UNIT (MXL) & HSSD POWER SUPPLY |
| HSSD | | IEI VESDA HSSD DETECTOR |
| AV-01 | ①S | STROBE, NUMBER & MINIMUM CANDELA RATING |
| AV-02 | ②H | HORN/STROBE, NUMBER AND MINIMUM CANDELA |
| L1-05 | ⑤S | SPRINKLER VALVE SUPERVISORY SWITCH, ADDRESS AS NOTED |
| L1-06 | ⑥ | SPRINKLER WATERFLOW SWITCH, ADDRESS AS NOTED |
| TR | ①R | INTELLIGENT INTERFACE MODULE (TRI-R UNLESS NOTED OTHERWISE) |
| COL | | END-OF-LINE DEVICE |
| LP | ①P | EXISTING FENWAL 2210 HALON RELEASING PANEL |
| FSD | | COMBINATION SMOKE FIRE DAMPER. SEE HVAC PLANS FOR DUCT AND DAMPER LOCATIONS. |
| | — | HSSD SAMPLE PIPING AND SAMPLE PORT |
| L1 | ① | FIRE ALARM CONDUIT (3/4-INCH). SEE NOTES PROVIDED ON EACH PLAN FOR CIRCUITS. |
| AV1 | ① | 1 PAIR; SLC/ALD LOOP (L1) (SEE RACEWAY NOTES ON EACH FLOOR PLAN) |
| AV1 | ② | 1 PAIR #1/4; NOTIFICATION APPLIANCE CIRCUIT (SEE RACEWAY NOTES ON EACH FLOOR PLAN) |

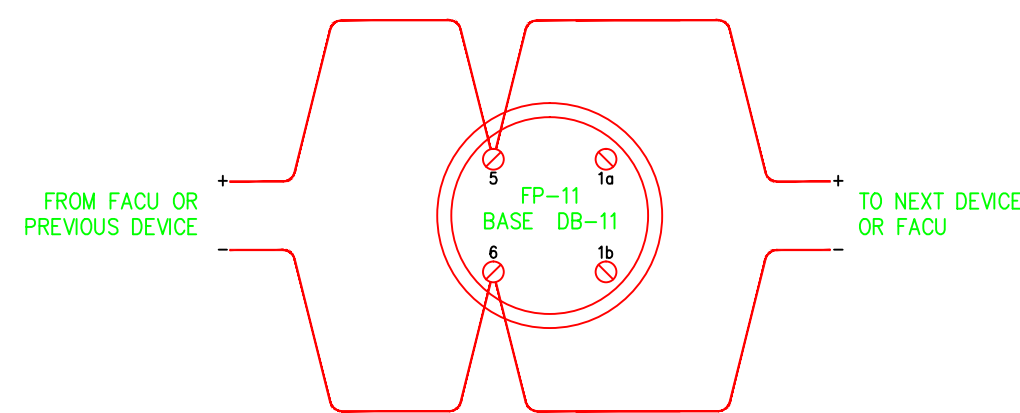

<div>ASBUILT A 05/20/2013</div>									BLDG-15 FIRE ALARM GENERAL NOTES, LEGEND & DETAILS	DRAWN BY	DSV	DATE	05/20/2013	
										CHECKED BY	LDD		05/20/2013	
										APPROVED BY	MCD		05/20/2013	
										SCALE				NONE
										DRAWING NO.		SHEET		
										4B15E057A		01		
PROFESSIONAL SEAL (F. REGION, APPLIES ONLY TO REVISION WORK)	ISSUE	(PROGRESS, ESTIMATE, BID, CONSTRUCTION, CONFIRMED, REVISION, ETC.)	REVISION NUMBER	DRAWN BY	CHECKED BY	APPR'D BY	DATE	REMARKS	UNIVERSITY OF CALIFORNIA LAWRENCE BERKELEY NATIONAL LABORATORY FACILITIES DIVISION	PROJECT NO.	FN1438	1 OF 9		